

STATE ENGINEER
Salem, Oregon

MAR 1 1942
14445
MAR 1

Well Record


STATE WELL NO. 9/2W-25L
COUNTY Marion
APPLICATION NO. GR-3827

OWNER: William Towery MAILING ADDRESS: Route 1, Box 151

LOCATION OF WELL: Owner's No. CITY AND STATE: Turner, Oregon

Well # 4
NE 1/4 SW 1/4 Sec. 25 T. 9 S., R. 2 W., W.M.

Bearing and distance from section or subdivision
corner 155' E. & 742' N. of NE Cor. of SW 1/4 of SW 1/4

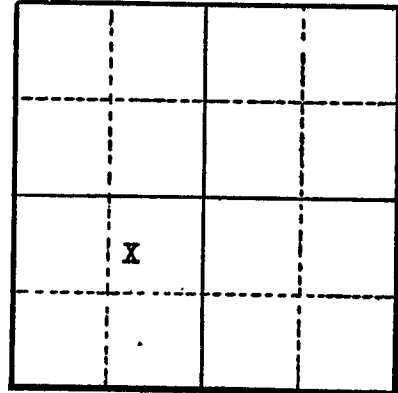

Section 25

Altitude at well

TYPE OF WELL: Drilled. Date Constructed Apr., 1942

Depth drilled 26 feet. Depth cased 26 feet

CASING RECORD:

8 inch casing set to 26 feet

FINISH:

3 - 3/8" x 6" per foot from 10 to 26 feet

AQUIFERS:

WATER LEVEL:

9 feet below surface

PUMPING EQUIPMENT: Type Fairbanks Morse centrifugal 3" H.P. 15
Capacity 350 G.P.M.

WELL TESTS:

Drawdown 2.5 ft. after 450 hours G.P.M.
Drawdown ft. after hours G.P.M.

USE OF WATER Irrigation Temp. °F., 19

SOURCE OF INFORMATION Well Registration Statement

DRILLER or DIGGER

ADDITIONAL DATA:

Log Water Level Measurements Chemical Analysis Aquifer Test

REMARKS:

Log:	Thickness	Depth to Bottom
Sub soil	6	6
Sand & gravel	5	11
Water gravel	15	26