

STATE ENGINEER
Salem, Oregon

14448
M 3 51
ARI
.....

Well Record

GR 1208


STATE WELL NO. 9/2W-25M
COUNTY Marion
APPLICATION NO. GR-1252

OWNER: Louis G. Scofield Mailing Address: Rt. 1, Box 148

LOCATION OF WELL: Owner's No. CITY AND STATE: Turner, Oregon

NW 1/4 SW 1/4 Sec. 25 T. 9 S. R. 2 W., W.M.

Bearing and distance from section or subdivision
corner 3330' N. & 882.1' W. to NW cor. Sec. 25.

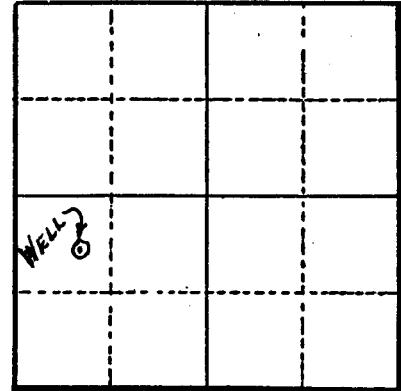

Section 25

Altitude at well

TYPE OF WELL: Drilled Date Constructed 1952

Depth drilled 21 ft. Depth cased 21 ft.

CASING RECORD:

8 inch

FINISH:

Perforated from 9 to 21 ft.

AQUIFERS:

WATER LEVEL:

10 ft.

PUMPING EQUIPMENT: Type Pacific 4 x 3 in. H.P. 15

Capacity 400 G.P.M.

WELL TESTS:

Drawdown 30 in. after 400 G.P.M.

Drawdown ft. after hours G.P.M.

USE OF WATER Irrigation Temp. °F., 19

SOURCE OF INFORMATION G. R. Record

DRILLER or DIGGER

ADDITIONAL DATA:

Log N.A. Water Level Measurements Chemical Analysis Aquifer Test

REMARKS:

Irrigation of 35.45 acres.