

STATE ENGINEER
Salem, Oregon

1446
MARI...

Well Record

GR- 1335

STATE WELL NO. 3 250
4/W 36B
COUNTY Marion
APPLICATION NO. GR- 1378

OWNER: Theodore M. Van Dyke


MAILING ADDRESS: _____
Pg Lot 3

LOCATION OF WELL: Owner's No. #2

CITY AND STATE: St. Paul, Oregon

NW 1/4 NE 1/4 Sec. 36 T. 4 S. R. 2 W., W.M.

Bearing and distance from section or subdivision
corner 2175' S, 86°W. from SE cor. Sec. 25.

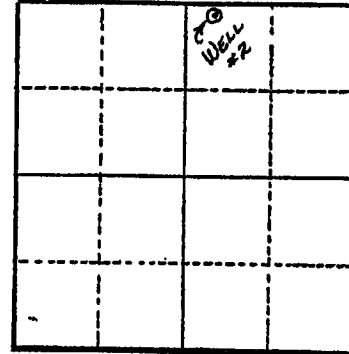

Section 36

Altitude at well _____

TYPE OF WELL: Drilled Date Constructed 1954

Depth drilled 76 ft. Depth cased 76 ft.

CASING RECORD:

10 inch

FINISH:

AQUIFERS:

WATER LEVEL:

10 to 12 ft. (Summer)

PUMPING EQUIPMENT: Type Peerless turbine

H.P. 30

Capacity 300 G.P.M.

WELL TESTS:

Drawdown _____ ft. after _____ hours _____ G.P.M.

Drawdown _____ ft. after _____ hours _____ G.P.M.

USE OF WATER Irrigation Temp. _____ °F. _____, 19____

SOURCE OF INFORMATION G. R. Record

DRILLER or DIGGER _____

ADDITIONAL DATA:

Log _____ Water Level Measurements _____ Chemical Analysis _____ Aquifer Test _____

REMARKS:

Log:	Clay	0 to 8 ft.
	Blue clay	8 to 51 ft.
	Fine black sand	51 to 52 ft.
	Gray clay	52 to 59 ft.
	Fine black sand	59 to 73 ft.
	Coarse black sand	73 to 76 ft.

Irrigation of 30 acres.

STATE ENGINEER
Salem, Oregon

MAR 1446 Well Record

STATE WELL NO. 4/3W-3681
COUNTY Marion
APPLICATION NO.

OWNER: Theodore Van Dyke

MAILING ADDRESS: Pg 2 of 3

LOCATION OF WELL: Owner's No.

CITY AND STATE:

1/4 1/4 Sec. T. N. E. S, R. W, W.M.

Bearing and distance from section or subdivision corner

Altitude at well 155

TYPE OF WELL: Drilled Date Constructed 1954

Depth drilled 76 Depth cased 76

Section

CASING RECORD:
10 inch

FINISH:

AQUIFERS:

Coarse, black sand from 73 to 76

WATER LEVEL:
10 feet

PUMPING EQUIPMENT: Type Turbine H.P. 30
Capacity G.P.M.

WELL TESTS:
Drawdown ft. after hours G.P.M.
Drawdown ft. after hours G.P.M.

USE OF WATER Irrigation--30 acres Temp. °F. 19

SOURCE OF INFORMATION USGS

DRILLER or DIGGER

ADDITIONAL DATA:
Log X Water Level Measurements Chemical Analysis Aquifer Test

REMARKS:

Flows in winter.

