

STATE ENGINEER
Salem, Oregon

Well Record

STATE WELL NO. 9/2W-26ad
COUNTY Marion
APPLICATION NO. GR-618

MARION PL44600
MARION

OWNER: Clarence Gavette

MAILING ADDRESS:


LOCATION OF WELL: Owner's No. 1

CITY AND STATE:

Turner, Oregon

SE 1/4 NE 1/4 Sec. 26 T. 9 S., R. 2 W., W.M.

Bearing and distance from section or subdivision corner South 2579 feet and West 1065 feet from the NE Corner, of Section 26

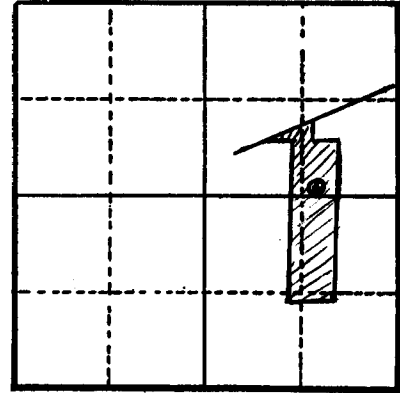

Section 26

Altitude at well 235 feet Interpolated

TYPE OF WELL: Dug Date Constructed April 1940

Depth drilled 21 Depth cased 21

CASING RECORD:

30-inch concrete

FINISH:

AQUIFERS:

WATER LEVEL:

13 feet

PUMPING EQUIPMENT: Type Pacific Centrifugal H.P. 15
Capacity 270 G.P.M.

WELL TESTS:

Drawdown ft. after hours G.P.M.
Drawdown ft. after hours G.P.M.

USE OF WATER Irrigation 32.8 acres Temp. °F., 19.....

SOURCE OF INFORMATION GR-671

DRILLER or DIGGER

ADDITIONAL DATA:

Log Water Level Measurements Chemical Analysis Aquifer Test

REMARKS: