

STATE ENGINEER  
Salem, Oregon

# Well Record

STATE WELL NO. 9/2W-26ad  
COUNTY Marion  
APPLICATION NO. GR-611

OWNER: Albert Lyons


MAILING ADDRESS: Route 1

LOCATION OF WELL: Owner's No. \_\_\_\_\_

CITY AND STATE: Turner, Oregon

SE 1/4 NE 1/4 Sec. 26 T. 9 S., R. 2 W., W.M.

Bearing and distance from section or subdivision  
corner North 7°35' East 2508.9 feet to NE Corner,  
Section 26

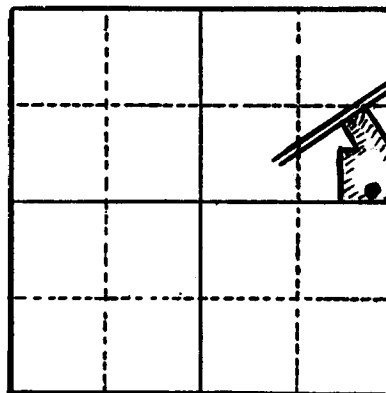

Section 26

Altitude at well 338 feet

TYPE OF WELL: Drilled Date Constructed 1947

Depth drilled 26 feet Depth cased 26 feet

### CASING RECORD:

8-inch

### FINISH:

### AQUIFERS:

WATER LEVEL: 13.65' (9-24-57)  
13 feet

PUMPING EQUIPMENT: Type Horizontal Centrifugal H.P. 10  
Capacity 200 G.P.M.

### WELL TESTS:

Drawdown \_\_\_\_\_ ft. after \_\_\_\_\_ hours \_\_\_\_\_ G.P.M.  
Drawdown \_\_\_\_\_ ft. after \_\_\_\_\_ hours \_\_\_\_\_ G.P.M.

USE OF WATER Irrigation 16.2 acres Temp. \_\_\_\_\_ °F. \_\_\_\_\_, 19\_\_\_\_\_

SOURCE OF INFORMATION GR-581

DRILLER or DIGGER \_\_\_\_\_

### ADDITIONAL DATA:

Log \_\_\_\_\_ Water Level Measurements \_\_\_\_\_ Chemical Analysis \_\_\_\_\_ Aquifer Test \_\_\_\_\_

### REMARKS:

see hydrograph  
silt soil 0 to 8 feet  
river gravel 8 to 26 feet