

OBSERVATION WELLS

Well Record

STATE ENGINEER
Salem, Oregon

MARION
12/16/63
GLEN TIERCE

STATE WELL NO. 9/2W-26A
COUNTY Marion
APPLICATION NO. GR-1254

GR- 1210

OWNER: Louis G. Scofield


MAILING ADDRESS: Rt. 1, Box 148

LOCATION OF WELL: Owner's No. #3

CITY AND STATE: Turner, Oregon

NE 1/4 NE 1/4 Sec. 26 T. 9 S., R. 2 W., W.M.

Bearing and distance from section or subdivision
corner 907.4' N. & 13.6' E. to NE cor. Sec. 26.

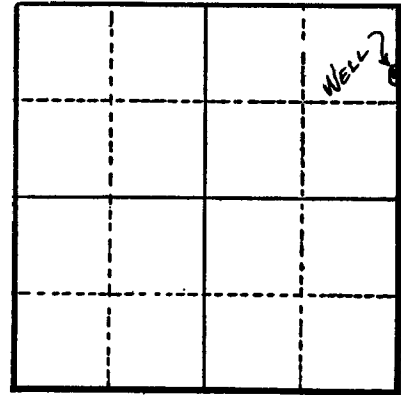

Section 26

Altitude at well 346 ft.

TYPE OF WELL: Drilled Date Constructed 1955

Depth drilled 42 ft. Depth cased 42 ft.

CASING RECORD:

8 inch

FINISH:

Perforated from 10 to 42 ft.

AQUIFERS:

WATER LEVEL: 6.48' (2-3-61) 19.28 (7-28-61)
9 - 10 ft. 4.92' (3-29-61) 8.71 (11-2-61)

PUMPING EQUIPMENT: Type Deep well turbine H.P. 10
Capacity 290 G.P.M.

WELL TESTS:

Drawdown ft. after hours G.P.M.
Drawdown ft. after hours G.P.M.

USE OF WATER Irrigation Temp. °F. 19

SOURCE OF INFORMATION G. R. Record

DRILLER or DIGGER Marion West

ADDITIONAL DATA:

Log N.A. Water Level Measurements Chemical Analysis Aquifer Test

REMARKS:

Irrigation of 43.9 acres.