

STATE ENGINEER
Salem, Oregon

MARION
44766
MARI

Well Record

STATE WELL NO. 9/2W-26E
COUNTY Marion
APPLICATION NO. GR-3442

OWNER: Wendel W. Clack


MAILING ADDRESS: 3749 Dunlap Ave.

LOCATION OF WELL: Owner's No.

CITY AND STATE: Albany, Oregon

SW 1/4 NW 1/4 Sec. 26 T. 9 N. S. R. 2 E. W., W.M.

Bearing and distance from section or subdivision corner 1980' S. and 330' E.

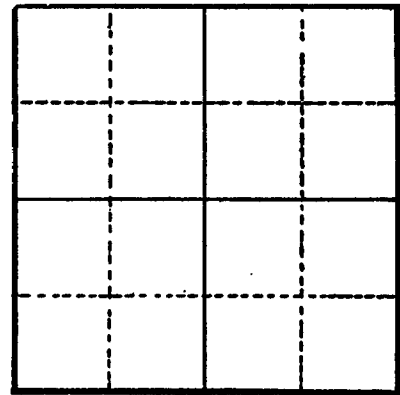

Section

Altitude at well

TYPE OF WELL: dug Date Constructed 1948

Depth drilled 15' Depth cased

CASING RECORD:

25' x 100'

FINISH:

AQUIFERS:

soil, coarse gravel

WATER LEVEL:

3'

PUMPING EQUIPMENT: Type 2" Cent. H.P. 7 1/2
Capacity 200 G.P.M.

WELL TESTS:

Drawdown ft. after hours G.P.M.
Drawdown ft. after hours G.P.M.

USE OF WATER Irrigation Temp. °F., 19

SOURCE OF INFORMATION GR-3183

DRILLER or DIGGER

ADDITIONAL DATA:

Log ^x Water Level Measurements Chemical Analysis Aquifer Test

REMARKS:

soil 3 3
coarse gravel 12 15