

STATE ENGINEER  
Salem, Oregon

# Well Record

STATE WELL NO. 9/2W-26J(1)  
COUNTY Marion  
APPLICATION NO. GR- 612

MARI  
7/14/67  
MARI

OWNER: Albert Lyons


MAILING ADDRESS: Rt. 1

LOCATION OF WELL: Owner's No. 2

CITY AND STATE: Turner, Oregon

NE 1/4 SE 1/4 Sec. 26 T. 9 S., R. 2 W., W.M.

Bearing and distance from section or subdivision  
corner N.6°23'E. 2981' to NE cor. of sec. 26

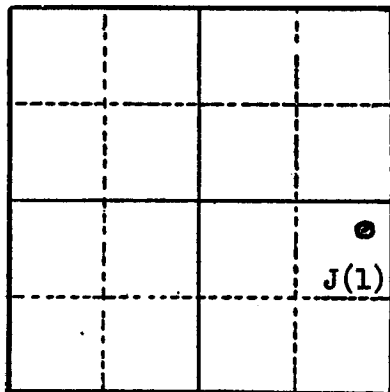

Section 26

Altitude at well 335'

TYPE OF WELL: Drilled Date Constructed 1945

Depth drilled 28' Depth cased 28'

CASING RECORD:  
8 inch

FINISH:

AQUIFERS:

WATER LEVEL:  
11 feet 12.44' (9-24-57)

PUMPING EQUIPMENT: Type Centrifugal H.P. 15  
Capacity 235 G.P.M.

WELL TESTS:  
Drawdown 6 or 8 ft. after 235 hours G.P.M.  
Drawdown ft. after hours G.P.M.

USE OF WATER Irrigation (25 acres) Temp. °F. 19

SOURCE OF INFORMATION GR- 582

DRILLER or DIGGER

ADDITIONAL DATA:  
Log X Water Level Measurements Chemical Analysis Aquifer Test

REMARKS:

River silt loam 0 to 8  
River gravel 8 to 28

See hydrograph