

STATE ENGINEER
Salem, Oregon


M 1 21.....
14469
MARI
Well Record

STATE WELL NO. 9/2W-26ac
COUNTY Marion
APPLICATION NO. GR-128

OWNER: Peter J. Kremer MAILING ADDRESS: Route 1, Box 144

LOCATION OF WELL: Owner's No. 1 CITY AND STATE: Turner, Oregon

SW 1/4 NE 1/4 Sec. 26 T. 9 S, R. 2 W., W.M.
Bearing and distance from section or subdivision
corner 590 feet North and 200 feet East from
center of Section 26

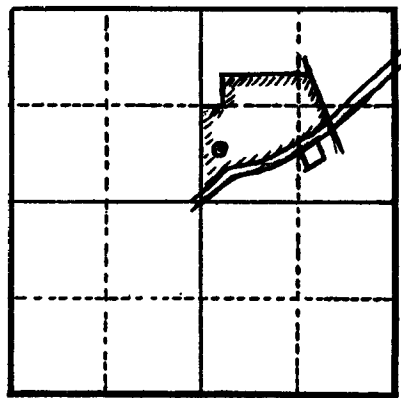

Section 26

Altitude at well 330 feet Interpolated

TYPE OF WELL: Drilled Date Constructed March 1950
Depth drilled 25 feet Depth cased 25 feet

CASING RECORD:
8-inch steel casing set from 0 to 25 feet

FINISH:
torch cut slots 6" x 1/4" set from 19 to 25 feet

AQUIFERS:
gravel from 5 to 25 feet memory log

WATER LEVEL:
5 feet below land surface March 1950 flows in winter seasons

PUMPING EQUIPMENT: Type Jacuzzi H.P. 15
Capacity 550 G.P.M.

WELL TESTS:
Drawdown 5 ft. after 600 hours G.P.M.
Drawdown ft. after hours G.P.M.

USE OF WATER Irrigation 55 acres Temp. °F. 19

SOURCE OF INFORMATION GR-119

DRILLER or DIGGER

ADDITIONAL DATA:
Log Water Level Measurements Chemical Analysis Aquifer Test

REMARKS:
log from memory clay 0 to 5 feet
(water) gravel 5 to 19 feet
(cemented) gravel 19 to 25 feet