

STATE ENGINEER
Salem, Oregon

Well Record

STATE WELL NO. 9/ZW-26R(1)
COUNTY Marion
APPLICATION NO. GR- 636

MARION.....
14487
MARION

OWNER: Clarence Gavette


MAILING ADDRESS:

LOCATION OF WELL: Owner's No. 2

CITY AND STATE: Turner, Oregon

SE 1/4 SE 1/4 Sec. 26 T. 9 S., R. 2 W., W.M.

Bearing and distance from section or subdivision corner S. 4279.7' by 150' W. of NE cor. of sec. 26

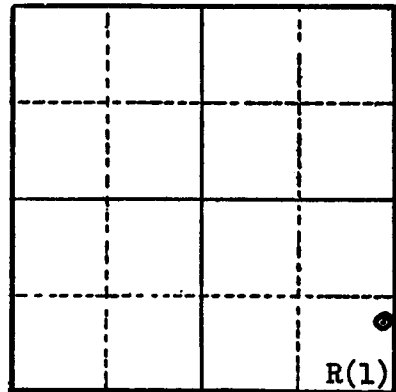

Altitude at well 325'

TYPE OF WELL: Drilled Date Constructed Mar. 1952

Depth drilled 20' Depth cased 20'

Section 26

CASING RECORD:

8 inch

FINISH:

AQUIFERS:

WATER LEVEL:

6 feet

PUMPING EQUIPMENT: Type Centrifugal H.P. 15

Capacity 400 G.P.M.

WELL TESTS:

Drawdown ft. after hours G.P.M.

Drawdown ft. after hours G.P.M.

USE OF WATER Irrigation (79 acres) Temp. °F., 19.....

SOURCE OF INFORMATION GR- 601

DRILLER or DIGGER

ADDITIONAL DATA:

Log X Water Level Measurements Chemical Analysis Aquifer Test

REMARKS:

River silt 0 to 6
River gravel 6 to 20