

STATE ENGINEER
Salem, Oregon

MARI 1449

Well Record

STATE WELL NO. 4/3W-360
COUNTY Marion
APPLICATION NO. GR-3273

OWNER: Charles F. & Leona C. Pelland


MAILING ADDRESS: Star Route, Box 19

LOCATION OF WELL: Owner's No. #1

CITY AND STATE: St. Paul, Oregon

SW 1/4 SE 1/4 Sec. 36 T. 4 N. S. R. 3 E. W., W.M.

Bearing and distance from section or subdivision corner 21 1/2 ch. W. & 1/2 ch. N. from SE cor. Sec. 36

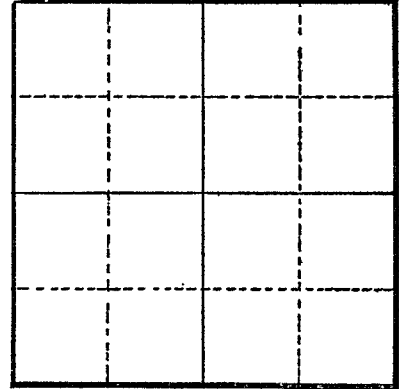

Section

Altitude at well

TYPE OF WELL: drilled Date Constructed 1949

Depth drilled 251 Depth cased 244

CASING RECORD:

10 inch

FINISH:

AQUIFERS:

Sand, gravel, and clay

WATER LEVEL:

31 feet

PUMPING EQUIPMENT: Type Pomona H.P. 30
Capacity 575 G.P.M.

WELL TESTS:

Drawdown 124 ft. after hours Pumping 575 G.P.M.

Drawdown ft. after hours G.P.M.

USE OF WATER Irrigation Temp. °F., 19.

SOURCE OF INFORMATION GR-3044

DRILLER or DIGGER

ADDITIONAL DATA:

Log Water Level Measurements Chemical Analysis Aquifer Test

REMARKS:

