

STATE ENGINEER
Salem, Oregon

MARI
MARI

Well Record

STATE WELL NO. 9/2W-27A
COUNTY MARION
APPLICATION NO. GR-2916

OWNER: Roger G. Wheeler


MAILING ADDRESS: Rt. 1, Box 127

LOCATION OF WELL: Owner's No.

CITY AND STATE: Turner, Oregon

NE 1/4 NE 1/4 Sec. 27 T. 9 N. S., R. 2 E. W., W.M.

Bearing and distance from section or subdivision corner 490' W. and 750' S.

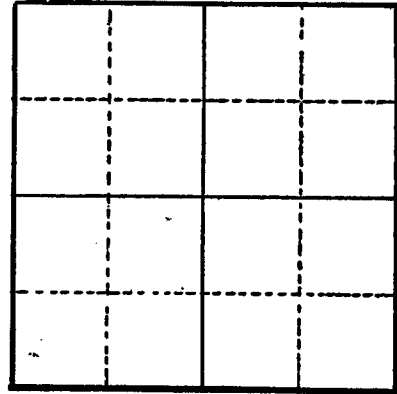

Section

Altitude at well

TYPE OF WELL: dug Date Constructed 1948

Depth drilled 16 Depth cased

CASING RECORD:

FINISH:

AQUIFERS:

WATER LEVEL:

3-feet

PUMPING EQUIPMENT: Type Centrifugal H.P. 7 1/2
Capacity 128 G.P.M.

WELL TESTS:
Drawdown 8 ft. after Pumping 100 hours G.P.M.
Drawdown ft. after hours G.P.M.

USE OF WATER Irrigation Temp. °F. 19

SOURCE OF INFORMATION GR-2744

DRILLER or DIGGER

ADDITIONAL DATA:

Log Water Level Measurements Chemical Analysis Aquifer Test

REMARKS: