

STATE ENGINEER
Salem, Oregon

MARION 14493
Well Record

STATE WELL NO. 9/2W - 27E
COUNTY MARION
APPLICATION NO. GR-2162

OWNER: William F. Watson


MAILING ADDRESS: Route 1, Box 60

LOCATION OF WELL: Owner's No.

CITY AND STATE: Turner, Oregon

SW 1/4 NW 1/4 Sec. 27 T. 9 N. S. R. 2 W., W.M.

Bearing and distance from section or subdivision corner 660' E. and 957' N.

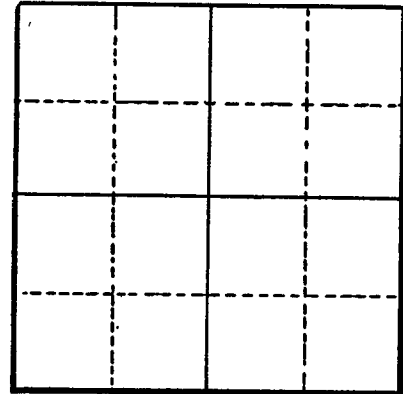

Section

Altitude at well

TYPE OF WELL: Dug Date Constructed 1952

Depth drilled 16 Depth cased

CASING RECORD:

FINISH:

AQUIFERS:

Gravel

WATER LEVEL:

PUMPING EQUIPMENT: Type Pacific Centrifugal H.P. 12
Capacity 180 G.P.M.

WELL TESTS:

Drawdown ft. after hours G.P.M.
Drawdown ft. after hours G.P.M.

USE OF WATER Irrigation Temp. °F., 19

SOURCE OF INFORMATION GR-2072

DRILLER or DIGGER

ADDITIONAL DATA:

Log X Water Level Measurements Chemical Analysis Aquifer Test

REMARKS:

Gravel and blue mud mixture 16 16