

STATE ENGINEER M.A. ...
Salem, Oregon

MARI
14494
MARI


Well Record

STATE WELL NO. 9/2W-27J
COUNTY Marion
APPLICATION NO. GR-3254

OWNER: Rose Jones MAILING ADDRESS: Box 67

LOCATION OF WELL: Owner's No. CITY AND STATE: Marion, Oregon

NE 1/4 SE 1/4 Sec. 27 T. 9 S., R. 2 W., W.M.
Bearing and distance from section or subdivision
corner 350' S. and 230' W. from E1/2 Corner
Section 27

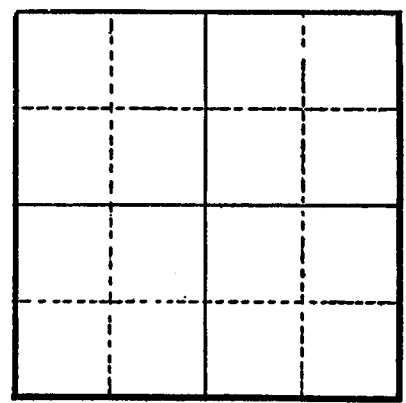

Section

Altitude at well

TYPE OF WELL: drilled Date Constructed 1951

Depth drilled 57' Depth cased 57'

CASING RECORD:

8 inch

FINISH:

1/2" x 6" slots - torch from 17 to 57

AQUIFERS:

soil, clay, sand and gravel

WATER LEVEL:

9'

PUMPING EQUIPMENT: Type Fairbanks Turbine H.P. 7 1/2

Capacity 80 G.P.M.

WELL TESTS:

Drawdown 13 ft. after hours pumping 60 G.P.M.

Drawdown ft. after hours G.P.M.

USE OF WATER Irrigation Temp. °F. 19

SOURCE OF INFORMATION GR-3027

DRILLER or DIGGER D. C. Jones

ADDITIONAL DATA:

Log Water Level Measurements Chemical Analysis Aquifer Test

REMARKS:

Top soil	0	4
Clay, sand	4	10
Sand, gravel	10	54
Gravel, clean		
water bearing	54	57