

STATE ENGINEER  
Salem, Oregon

MAR. 1955  
MAR 1

# Well Record

STATE WELL NO. 9/2W-27P(1)  
COUNTY Marion  
APPLICATION NO. GR-1181

GR- 1142

OWNER: Opha D. Wilkinson


MAILING ADDRESS: Rt. 1, Box 114

LOCATION OF WELL: Owner's No.

CITY AND STATE: Turner, Oregon

SE 1/4 SW 1/4 Sec. 27 T. 9 S, R. 2 W, W.M.

Bearing and distance from section or subdivision corner 462' N. & 858' W. from SE cor. of Sec. 27.

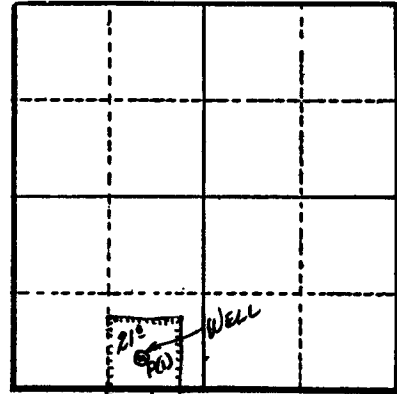

Altitude at well 315 ft.

TYPE OF WELL: Drilled Date Constructed 1951

Depth drilled 120 ft. Depth cased 120 ft.

Section 27

### CASING RECORD:

8 inch

### FINISH:

### AQUIFERS:

### WATER LEVEL:

5 ft.

PUMPING EQUIPMENT: Type Smith Deep Well Turbine 6 in. bowls H.P. 5  
Capacity 117 G.P.M.

### WELL TESTS:

Drawdown 100 ft. after 117 hours G.P.M.

Drawdown ft. after hours G.P.M.

USE OF WATER Irrigation Temp. °F. 19

SOURCE OF INFORMATION G. R. Record

DRILLER or DIGGER Clement Bros.

### ADDITIONAL DATA:

Log N.A. Water Level Measurements Chemical Analysis Aquifer Test

### REMARKS:

Irrigation of 35 acres.