

STATE ENGINEER  
Salem, Oregon

M 3 31  
14496  
MARI

# Well Record

STATE WELL NO. 9/2W-27Q(1)  
COUNTY Marion  
APPLICATION NO. GR- 117

OWNER: A.B. Hinz


MAILING ADDRESS: \_\_\_\_\_

LOCATION OF WELL: Owner's No. 2

CITY AND STATE: Jefferson, Oregon

SW 1/4 SE 1/4 Sec. 27 T. 9 S., R. 2 W., W.M.

Bearing and distance from section or subdivision  
corner 1740' W. & 500' N. of SE cor. of sec. 27

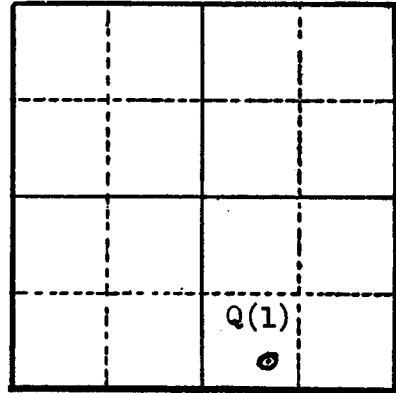

Altitude at well 320' (Interpolated)

Section 27

TYPE OF WELL: Drilled Date Constructed 1950

Depth drilled 130' Depth cased 128'

### CASING RECORD:

8 inch from 0 to 128 feet

### FINISH:

Mills knife slots from 20 to 128 feet

### AQUIFERS:

Gravel

### WATER LEVEL:

25 feet below land surface

PUMPING EQUIPMENT: Type F. M. H.P. 25  
Capacity 400 G.P.M.

### WELL TESTS:

Drawdown 120 ft. after \_\_\_\_\_ hours 300 G.P.M.

Drawdown \_\_\_\_\_ ft. after \_\_\_\_\_ hours \_\_\_\_\_ G.P.M.

USE OF WATER Irrigation (106 acres) Temp. \_\_\_\_\_ °F. 19

SOURCE OF INFORMATION GR- 108

DRILLER or DIGGER Marion West

### ADDITIONAL DATA:

Log NA Water Level Measurements \_\_\_\_\_ Chemical Analysis \_\_\_\_\_ Aquifer Test \_\_\_\_\_

### REMARKS: