

STATE ENGINEER  
Salem, Oregon

74497  
MARION  
M 1 21.....

# Well Record

STATE WELL NO. 9/2W-27R(1)  
COUNTY Marion  
APPLICATION NO. GR- 117

OWNER: A.B. Hinz

MAILING ADDRESS:


LOCATION OF WELL: Owner's No. 1

CITY AND STATE:

Jefferson, Oregon

SE 1/4 SE 1/4 Sec. 27 T. 9 S., R. 2 W., W.M.

Bearing and distance from section or subdivision corner 850' N. & 340' W. from SE cor. of sec. 27

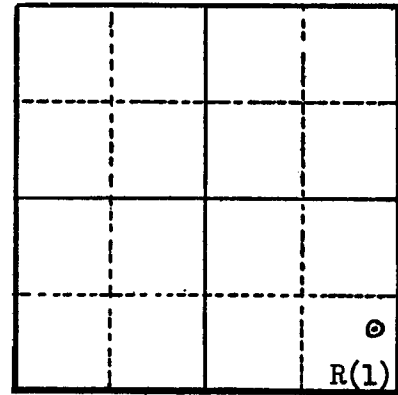

Section 27

Altitude at well 325' (Interpolated)

TYPE OF WELL: Drilled Date Constructed 12/10/48

Depth drilled 105' Depth cased 105'

### CASING RECORD:

8 inch set from 0 to 105 feet

### FINISH:

Mills knife slots from 25 to 105 feet

### AQUIFERS:

Gravel from 10 to 105 feet (Memory log)

### WATER LEVEL:

25 feet below land surface

### PUMPING EQUIPMENT: Type

H.P.

Capacity G.P.M.

### WELL TESTS:

Drawdown 100 ft. after hours 200 G.P.M.

Drawdown ft. after hours G.P.M.

USE OF WATER Irrigation (106 acres) Temp. °F., 19.

SOURCE OF INFORMATION GR- 108

DRILLER or DIGGER Marion West

### ADDITIONAL DATA:

Log X Water Level Measurements Chemical Analysis Aquifer Test

### REMARKS:

Clay 0 to 10 )  
Gravel 10 to 105 ) Log by memory