

STATE ENGINEER
Salem, Oregon

Well Record

STATE WELL NO. 9/2W-28K
COUNTY Marion
APPLICATION NO. GR-1394

M 171.44
14537
MARKI

GR-1350

OWNER: Warren Gray


MAILING ADDRESS: Rt. 1, Box 63

LOCATION OF WELL: Owner's No.

CITY AND STATE: Turner, Oregon

NW 1/4 SE 1/4 Sec. 28 T. 9 S., R. 2 W., W.M.

Bearing and distance from section or subdivision corner 1914' N. & 1518' W. from SE cor. Sec. 18

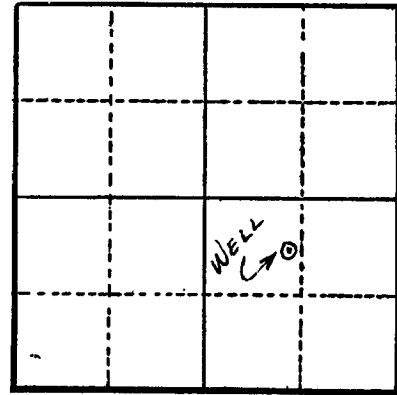

Section 28

Altitude at well

TYPE OF WELL: Drilled Date Constructed 1941

Depth drilled 63 ft. Depth cased 63 ft.

CASING RECORD:

10 inch

FINISH:

AQUIFERS:

WATER LEVEL:

4 ft.

PUMPING EQUIPMENT: Type Goulds 2 in. Cent. H.P. 10

Capacity 200 G.P.M.

WELL TESTS:

Drawdown 8 ft. after 150 hours G.P.M.

Drawdown ft. after hours G.P.M.

USE OF WATER Irrigation Temp. °F. 19

SOURCE OF INFORMATION G. R. Record

DRILLER or DIGGER Wells

ADDITIONAL DATA:

Log N.A. Water Level Measurements Chemical Analysis Aquifer Test

REMARKS:

Irrigation of 11.3 acres.