

STATE ENGINEER
Salem, Oregon

1466 Well Record
MARI.....

STATE WELL NO. 5/1W-3B
COUNTY Marion
APPLICATION NO. GR-3698

OWNER: Robert Nelson

MAILING ADDRESS: Box 259

Pg 1 of 3

LOCATION OF WELL: Owner's No.

CITY AND STATE: Hubbard, Oregon

NW 1/4 NE 1/4 Sec. 3 T. 5 S., R. 1 W., W.M.

Bearing and distance from section or subdivision

corner 700' n/1 E. and 401 S. of S₁ cor. Sec. 34

		X	

Section 3

Altitude at well

TYPE OF WELL: Drilled Date Constructed 8/12/54

Depth drilled 101 feet Depth cased 100 feet

CASING RECORD:

8 inch casing set to 100 feet

FINISH:

AQUIFERS:

WATER LEVEL:

23 feet below surface

PUMPING EQUIPMENT: Type Fairbanks Morse turbine H.P. 5
Capacity G.P.M.

WELL TESTS:

Drawdown 50 ft. after 200 hours G.P.M.

Drawdown ft. after hours G.P.M.

USE OF WATER Irrigation Temp. °F. 19

SOURCE OF INFORMATION Well Registration Statement

DRILLER or DIGGER

ADDITIONAL DATA:

Log X Water Level Measurements Chemical Analysis Aquifer Test

REMARKS:

STATE ENGINEER
Salem, Oregon

MARION
1466

Well Record

STATE WELL NO. 5/LW-3B(1)
COUNTY Marion
APPLICATION NO.

Pg 3 of 3

OWNER: Robert Nelson


MAILING ADDRESS:

LOCATION OF WELL: Owner's No.

CITY AND STATE:

..... ¼ ¼ Sec. T. N. E. S, R. W., W.M.

Bearing and distance from section or subdivision corner

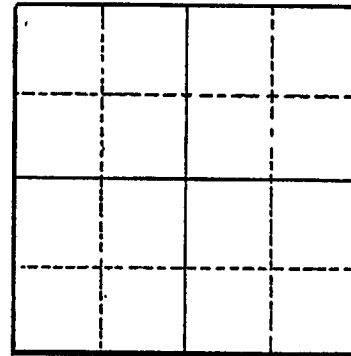

Section

Altitude at well 171

TYPE OF WELL: Drilled Date Constructed 1954

Depth drilled 101 Depth cased 100

CASING RECORD:

8 inch

FINISH:

Open bottom, casing unperforated

AQUIFERS:

Coarse sand from 99 to 101

WATER LEVEL:

23 feet below land surface on August 18, 1954

PUMPING EQUIPMENT: Type

H.P.

Capacity G.P.M.

WELL TESTS:

Drawdown ft. after hours G.P.M.

Drawdown ft. after hours G.P.M.

USE OF WATER Irrigation--5 acres Temp. °F. 19

SOURCE OF INFORMATION USGS

DRILLER or DIGGER

ADDITIONAL DATA:

Log Water Level Measurements Chemical Analysis Aquifer Test

REMARKS: