

STATE ENGINEER
Salem, Oregon

MARI...
14725
MARI

Well Record

STATE WELL NO. 9/2W-34E(1)
COUNTY Marion
APPLICATION NO. GR-1197


GR- 1158

OWNER: Edna A. Comerford
MAILING ADDRESS: Rt. 1, Box 112

LOCATION OF WELL: Owner's No. _____
CITY AND STATE: Turner, Oregon

SW 1/4 NW 1/4 Sec. 34 T. 9 S., R. 2 W., W.M.

Bearing and distance from section or subdivision
corner 1716' S. & 594' E. from NW cor. of Sec. 34.

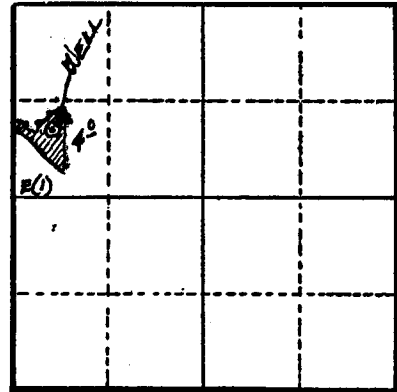

Section 34

Altitude at well 315 ft.

TYPE OF WELL: Drilled Date Constructed 1946

Depth drilled 50 ft. Depth cased 49 ft.

CASING RECORD:

6 inch from 0 to 49 ft.

FINISH:

AQUIFERS:

WATER LEVEL:

10 ft.

PUMPING EQUIPMENT: Type Jacuzzi jet H.P. 2

Capacity 18 G.P.M.

WELL TESTS:

Drawdown _____ ft. after _____ hours _____ G.P.M.

Drawdown _____ ft. after _____ hours _____ G.P.M.

USE OF WATER Irrigation Temp. _____ °F., 19

SOURCE OF INFORMATION G. R. Record

DRILLER or DIGGER _____

ADDITIONAL DATA:

Log N.A. Water Level Measurements _____ Chemical Analysis _____ Aquifer Test _____

REMARKS:

Irrigation of 4 acres.