

STATE ENGINEER
Salem, Oregon

MARI... 14.75

Well Record

STATE WELL NO. 5/1W-3D 1
COUNTY MARION
APPLICATION NO. GR-2554

OWNER: William C. Veal

MAILING ADDRESS: Rt. 1, Box 266,


LOCATION OF WELL: Owner's No.

CITY AND STATE: Hubbard, Oregon

NW 1/4 NW 1/4 Sec. 3 T. 5 S. R. 1 W., W.M.

Bearing and distance from section or subdivision

corner 1310' E. & 450' S.

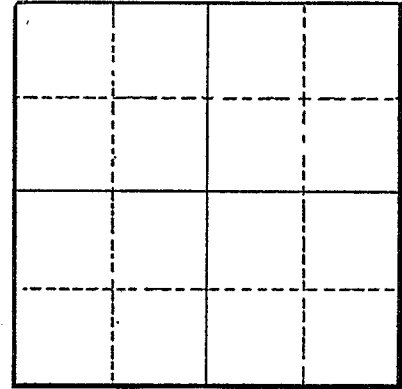

Section

Altitude at well

TYPE OF WELL: Drilled Date Constructed 1954

Depth drilled 117 Depth cased 117

CASING RECORD:

8-inch

FINISH:

Yes - slots from 110 to 113

AQUIFERS:

Topsoil, clay, sand and gravel

WATER LEVEL:

14' 9"

PUMPING EQUIPMENT: Type Fairbanks Morse Centrifugal H.P.
Capacity 120 G.P.M.

WELL TESTS:

Drawdown 77 ft. after hours Pumping 140 G.P.M.

Drawdown ft. after hours G.P.M.

USE OF WATER Irrigation Temp. °F., 19

SOURCE OF INFORMATION GR-2413

DRILLER or DIGGER J. T. Miller

ADDITIONAL DATA:

Log Water Level Measurements Chemical Analysis Aquifer Test

REMARKS:

Topsoil	0	22
Sandy clay	22	55
Sand	55	97
Sand gravel	97	117