

STATE ENGINEER  
Salem, Oregon

1478  
MARI.....

# Well Record

STATE WELL NO. 5/1W-3M(1)  
COUNTY Marion  
APPLICATION NO. GR-62

OWNER: Ambrose J. Heer

MAILING ADDRESS: Route 1, Box 74

LOCATION OF WELL: Owner's No. 1

CITY AND STATE: Woodburn, Oregon

NW 1/4 SW 1/4 Sec. 3 T. 5 S., R. 1 W., W.M.

Bearing and distance from section or subdivision

corner 58 chains W. of SE cor. of J. Purvine

DLC 60 in Sec. 3, T. 5 S., R. 1 W., 400'


N. of road, or 600' E. & 1600' N. from

SW cor. Sec. 3

Altitude at well Interpolated

TYPE OF WELL: Drilled Date Constructed 7/15/53

Depth drilled 140' Depth cased 140'

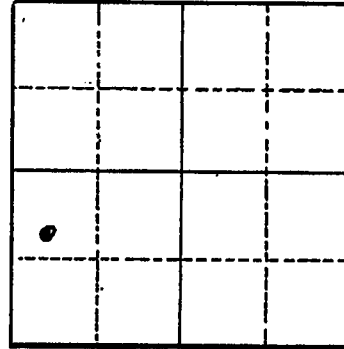

Section 3

### CASING RECORD:

8 inch steel casing set from 0 to 140 feet

### FINISH:

Perforations set from 120 to 138 feet

### AQUIFERS:

Gravel from 95 to 140 feet

### WATER LEVEL:

20 feet below land surface August 6, 1953

PUMPING EQUIPMENT: Type Turbine Jaouzzi H.P. 15  
Capacity 200 G.P.M.

### WELL TESTS:

Drawdown 100 ft. after          hours 260 G.P.M.

Drawdown 90 ft. after          hours 200 G.P.M.

USE OF WATER Irrigation Temp.          °F.         , 19        

SOURCE OF INFORMATION GR-62

DRILLER or DIGGER         

### ADDITIONAL DATA:

Log X Water Level Measurements          Chemical Analysis          Aquifer Test         

### REMARKS:

