

STATE ENGINEER
Salem, Oregon

M 121.....
14887

Well Record

STATE WELL NO. 9/3W-5N(1)
COUNTY Marion
APPLICATION NO. GR-1169

GR- 1130

OWNER: Eddie & Hazel G. Fish


MAILING ADDRESS: Rt. 3, Box 780

LOCATION OF WELL: Owner's No.

CITY AND STATE: Salem, Oregon

SW 1/4 SW 1/4 Sec. 5 T. 9 S. R. 3 W. W.M.

Bearing and distance from section or subdivision corner 1815' W. & 561' N. from S 1/4 cor. of Sec. 5.

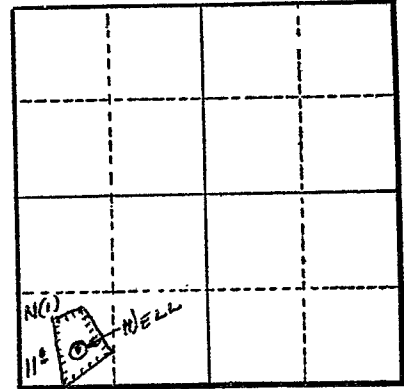

Section 5

Altitude at well 196 ft.

TYPE OF WELL: Drilled Date Constructed 1943

Depth drilled 100ft. Depth cased 78 ft.

CASING RECORD:

6 in. from 0 to 78 ft.

FINISH:

AQUIFERS:

WATER LEVEL:

30 ft.

PUMPING EQUIPMENT: Type Jacuzzi jet H.P. 5

Capacity 56 G.P.M.

WELL TESTS:

Drawdown ft. after hours G.P.M.

Drawdown ft. after hours G.P.M.

USE OF WATER Irrigation Temp. °F. 19

SOURCE OF INFORMATION G. R. Record

DRILLER or DIGGER H. E. Evans

ADDITIONAL DATA:

Log N.A. Water Level Measurements Chemical Analysis Aquifer Test

REMARKS:

Irrigation of 11 acres.