

STATE ENGINEER  
Salem, Oregon

MAR 1948  
15101

# Well Record

STATE WELL NO. 9/3W-18M(2)  
COUNTY Marion  
APPLICATION NO. GR-1106

GR- 1066

OWNER: Glenn Edwards


MAILING ADDRESS: Rt. 1

LOCATION OF WELL: Owner's No. #1

CITY AND STATE: Jefferson, Oregon

NW 1/4 SW 1/4 Sec. 18 T. 9 S., R. 3 W., W.M.

Bearing and distance from section or subdivision  
corner 1550' N. & 160' E. from SW cor. Sec. 18.

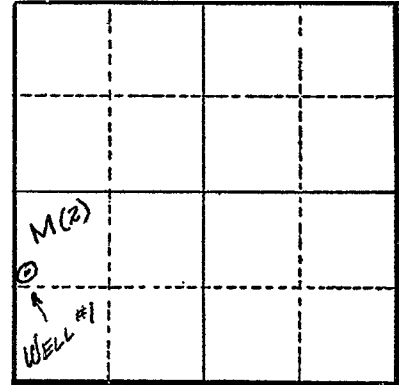

Section 18

Altitude at well 300 ft.

TYPE OF WELL: Drilled Date Constructed 1948

Depth drilled 35 ft. Depth cased 35 ft.

### CASING RECORD:

8 inch

### FINISH:

### AQUIFERS:

### WATER LEVEL:

12 ft.

PUMPING EQUIPMENT: Type Cent. H.P. 5

Capacity 125 G.P.M.

### WELL TESTS:

Drawdown 6 ft. after 200 hours G.P.M.

Drawdown \_\_\_\_\_ ft. after \_\_\_\_\_ hours G.P.M.

USE OF WATER Irrigation Temp. \_\_\_\_\_ °F., 19\_\_\_\_\_

SOURCE OF INFORMATION G. R. Record

DRILLER or DIGGER Hamilton

### ADDITIONAL DATA:

Log N.A. Water Level Measurements \_\_\_\_\_ Chemical Analysis \_\_\_\_\_ Aquifer Test \_\_\_\_\_

### REMARKS:

Irrigation of 11.55 acres.