

STATE ENGINEER
Salem, Oregon

M 121
15102 Well Record

STATE WELL NO. 9/3W-18N
COUNTY MARION
APPLICATION NO. GR-2919

OWNER: Louise H. Johnston


MAILING ADDRESS: Rt. 1, Box 99

LOCATION OF WELL: Owner's No.

CITY AND STATE: Jefferson, Oregon

SW 1/4 SW 1/4 Sec. 18 T. 9 N. S. R. 3 E. W., W.M.

Bearing and distance from section or subdivision corner 1188' E. and 462' N.

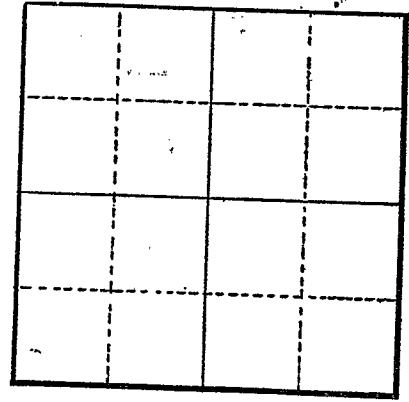

Section

Altitude at well

TYPE OF WELL: Drilled Date Constructed 1953

Depth drilled 50 Depth cased 50

CASING RECORD:

10-inch

FINISH:

1/2" x 12" 6 per foot from 41 to 50

AQUIFERS:

Topsoil, hardpan, clay, silt, sand and gravel

WATER LEVEL:

26-feet

PUMPING EQUIPMENT: Type Turbine

Capacity 150 G.P.M. H.P. 7 1/2

WELL TESTS:

Drawdown 19 ft. after hours Pumping 135 G.P.M.

Drawdown ft. after hours G.P.M.

USE OF WATER Irrigation

SOURCE OF INFORMATION GR-2749 Temp. °F. 19

DRILLER or DIGGER

ADDITIONAL DATA:

Log X Water Level Measurements Chemical Analysis Aquifer Test

REMARKS:

Topsoil	3	3
Hardpan	1	4
Blue clay	34	38
Silt & Sand	3	41
Gravel	9	50
Blue clay	5+	--