

STATE ENGINEER
Salem, Oregon

Well Record

STATE WELL NO. 9/3W-18P
COUNTY MARION
APPLICATION NO. GR-2498

M 171
15103

OWNER: Forrest Freitag


MAILING ADDRESS: Rt. 1, Box 94

LOCATION OF WELL: Owner's No. _____

CITY AND STATE: Jefferson, Oregon

SE $\frac{1}{4}$ SW $\frac{1}{4}$ Sec. 18 T. 9 S., R. 3 W., W.M.

Bearing and distance from section or subdivision corner 528' N. & 198' W.

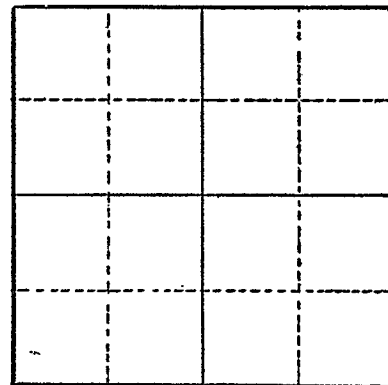

Section _____

Altitude at well _____

TYPE OF WELL: Drilled Date Constructed 1947

Depth drilled 45 Depth cased 45

CASING RECORD:

10-inch

FINISH:

Cut by torch about 0.3" wide

AQUIFERS:

Soil, clay, sand and gravel

WATER LEVEL:

PUMPING EQUIPMENT: Type Jacuzzi Jet Pump H.P. 5
Capacity 98 G.P.M.

WELL TESTS:

Drawdown _____ ft. after _____ hours _____ G.P.M.
Drawdown _____ ft. after _____ hours _____ G.P.M.

USE OF WATER Irrigation Temp. _____ °F., 19.

SOURCE OF INFORMATION GR-2365

DRILLER or DIGGER _____

ADDITIONAL DATA:

Log Water Level Measurements _____ Chemical Analysis _____ Aquifer Test _____

REMARKS:

Soil 3 3
Yellow Clay 22 25
Sand & gravel 20 45
Clay started at 45'