

STATE ENGINEER
Salem, Oregon

MARI. 1522

Well Record

STATE WELL NO. 5/IW-4N
COUNTY MARION
APPLICATION NO. GR-2907

OWNER: R. B. Smith & Mabel Fikan Smith


MAILING ADDRESS: Rt. 1, Box 85

LOCATION OF WELL: Owner's No.

CITY AND STATE: Woodburn, Oregon

SW 1/4 SW 1/4 Sec. 4 T. 5 N. S., R. 1 E. W., W.M.

Bearing and distance from section or subdivision corner 500' N. and 600' E.

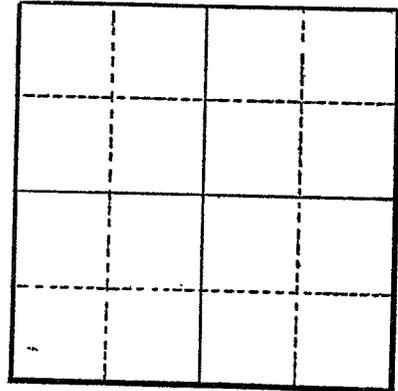

Section

Altitude at well

TYPE OF WELL: drilled Date Constructed 1921

Depth drilled 127 Depth cased 127

CASING RECORD:

4-inch

FINISH:

AQUIFERS:

WATER LEVEL:
20-feet

PUMPING EQUIPMENT: Type Jacuzzi Turbine H.P. 3
Capacity 40 G.P.M.

WELL TESTS:

Drawdown ft. after hours Pumping 40 G.P.M.
Drawdown ft. after hours G.P.M.

USE OF WATER Irrigation Temp. °F., 19

SOURCE OF INFORMATION GR-2736

DRILLER or DIGGER

ADDITIONAL DATA:

Log Water Level Measurements Chemical Analysis Aquifer Test

REMARKS: