

STATE ENGINEER
Salem, Oregon

MARI 1523

Well Record


STATE WELL NO. 5/1W-4P(1)
COUNTY Marion
APPLICATION NO. GR-623

OWNER: (Warren L. Calloway) R. B. Smith MAILING ADDRESS: Rt. 1, Box 72

LOCATION OF WELL: Owner's No. 1 CITY AND STATE: Woodburn, Oregon

SE 1/4 SW 1/4 Sec. 4 T. 5 S. R. 1 W., W.M.

Bearing and distance from section or subdivision corner 12.5 chains N. & 26.5 chains E. from SW corner, Sec. 4

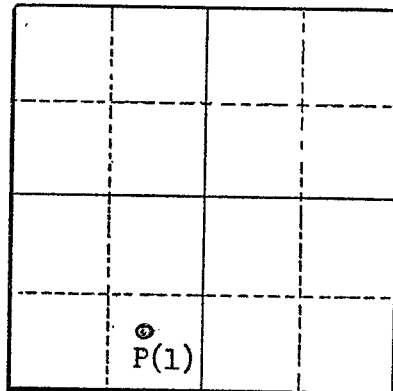

Section 4

Altitude at well 182 feet Interpolated

TYPE OF WELL: Drilled Date Constructed 8-11-50

Depth drilled 129 1/2 Depth cased 129 1/2

CASING RECORD:

10 inch

FINISH:

AQUIFERS:

WATER LEVEL:

20 feet

PUMPING EQUIPMENT: Type Berkeley Turbine H.P. 10
Capacity 350 G.P.M.

WELL TESTS:

Drawdown 40 ft. after 350 hours G.P.M.

Drawdown ft. after hours G.P.M.

USE OF WATER Domestic & irrigation 38 at temp. °F., 19

SOURCE OF INFORMATION GR-623

DRILLER or DIGGER Fred Wymore, Salem, Oregon

ADDITIONAL DATA:

Log Water Level Measurements Chemical Analysis Aquifer Test

REMARKS:

