

STATE ENGINEER  
Salem, Oregon


MARI... 1524

# Well Record

STATE WELL NO. 5/1W-4R  
COUNTY Marion  
APPLICATION NO. GR-4215

OWNER: Robert Brack MAILING ADDRESS: Route 1, Box 73  
CITY AND STATE: Woodburn, Oregon

LOCATION OF WELL: Owner's No. \_\_\_\_\_  
SE 1/4 SE 1/4 Sec. 4 T. 5 S. R. 1 W., W.M.  
Bearing and distance from section or subdivision  
corner 770' W. & 9920' N. from SE Cor. Sec. 4

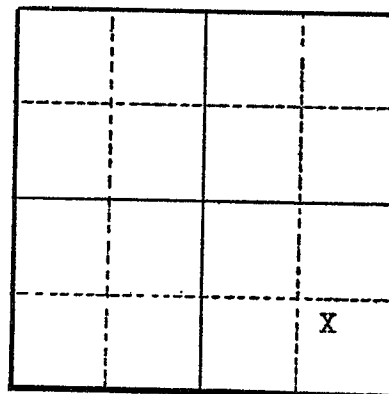

Section 4

Altitude at well \_\_\_\_\_

TYPE OF WELL: Drilled Date Constructed 10/49  
Depth drilled 116 ft. Depth cased 116 ft.

### CASING RECORD:

8 inch steel casing set to 116 feet

### FINISH:

Bottom 20 feet of casing perforated, from 96 to 116 feet

### AQUIFERS:

### WATER LEVEL:

25 feet below surface

PUMPING EQUIPMENT: Type Jacuzzi turbine H.P. 10  
Capacity 300 G.P.M.

### WELL TESTS:

Drawdown 15 ft. after \_\_\_\_\_ hours 338 G.P.M.  
Drawdown \_\_\_\_\_ ft. after \_\_\_\_\_ hours \_\_\_\_\_ G.P.M.

USE OF WATER Irrigation Temp. \_\_\_\_\_ °F. \_\_\_\_\_, 19

SOURCE OF INFORMATION Well Registration Statement Cert. # GR-3760

DRILLER or DIGGER Vernon Coleman

### ADDITIONAL DATA:

Log \_\_\_\_\_ Water Level Measurements \_\_\_\_\_ Chemical Analysis \_\_\_\_\_ Aquifer Test \_\_\_\_\_

### REMARKS: