

STATE ENGINEER
Salem, Oregon

Well Record

STATE WELL NO. 9/3W-29M(1)
COUNTY Marion
APPLICATION NO. GR- 85

MARI...
15327

OWNER: Albert E. Cole


MAILING
ADDRESS:

LOCATION OF WELL: Owner's No. 1

CITY AND
STATE: Jefferson, Oregon

NW 1/4 SW 1/4 Sec. 29 T. 9 S., R. 3 W., W.M.

Bearing and distance from section or subdivision
corner S.60°E. 910' from W₁ cor. as projected
within Reason Roby DLC #48

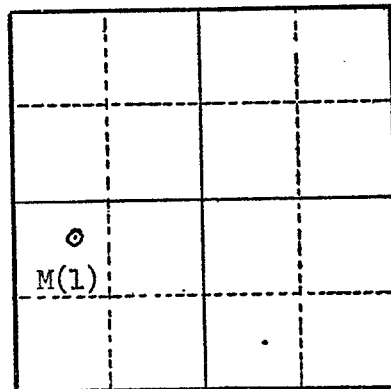

Altitude at well 190'

TYPE OF WELL: Drilled Date Constructed 3/11/53

Depth drilled 25' Depth cased 25'

Section 29

CASING RECORD:

8 inch set from 0 to 25 feet

FINISH:

Torch cut slots from 19 to 25 feet (3" X 1/2")

AQUIFERS:

River gravel from 13 to 25 feet

WATER LEVEL:

15 feet below land surface (3/12/53)

PUMPING EQUIPMENT: Type F.M. 1/4" 3-phase

H.P. 20

Capacity 380 G.P.M.

WELL TESTS:

Drawdown 3 ft. after hours 500 G.P.M.

Drawdown ft. after hours G.P.M.

USE OF WATER Irrigation (30 acres) Temp. °F., 19.....

SOURCE OF INFORMATION GR- 72

DRILLER or DIGGER Bill Hamilton, Albany

ADDITIONAL DATA:

Log X Water Level Measurements Chemical Analysis Aquifer Test

REMARKS:

River silt 0 to 12
River gravel 12 to 25

From memory.