

STATE ENGINEER
Salem, Oregon

15346
MAR 11 1948

Well Record

STATE WELL NO. 9/3W-30H(1)
COUNTY Marion
APPLICATION NO. GR-486

OWNER: David E. & Wilma B. Turnidge


MAILING ADDRESS:

LOCATION OF WELL: Owner's No. 12

CITY AND STATE: Jefferson, Oregon

SE 1/4 NE 1/4 Sec. 30 T. 9 S., R. 3 W., W.M.

Bearing and distance from section or subdivision corner 3630' N. & 1155' W. of SE cor. of sec. 30

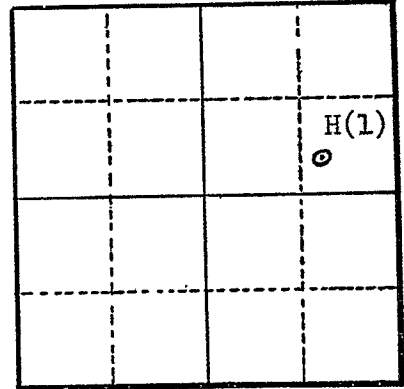

Section 30

Altitude at well 185'

TYPE OF WELL: Drilled Date Constructed 1948

Depth drilled 30' Depth cased 30'

CASING RECORD:

Crib - 10' X 4' X 3'

6 inch casing set from 10 to 30 feet

FINISH:

Slots from 18 to 30 feet

AQUIFERS:

Sand & gravel from 14 to 30 feet

WATER LEVEL:

10 feet below land surface

PUMPING EQUIPMENT: Type F. M.

H.P. 5

Capacity 125 G.P.M.

WELL TESTS:

Drawdown ft. after hours G.P.M.

Drawdown ft. after hours G.P.M.

USE OF WATER Irrigation (10 acres) Temp. °F. 19

SOURCE OF INFORMATION GR-468

DRILLER or DIGGER

ADDITIONAL DATA:

Log X Water Level Measurements Chemical Analysis Aquifer Test

REMARKS:

Sandy loam 0 to 14
Sand & gravel 14 to 30