

STATE ENGINEER
Salem, Oregon

Well Record

STATE WELL NO. 9/3M-30J
COUNTY MARION
APPLICATION NO. GR-2890

OWNER: Mr. & Mrs. Herman Kieper

MAILING
ADDRESS:


Jefferson, Oregon

LOCATION OF WELL: Owner's No. #1

CITY AND
STATE:

NE 1/4 SE 1/4 Sec. 30 T. 9 N. 3 E. W., W.M.

Bearing and distance from section or subdivision
corner 700' N. and 900' E.

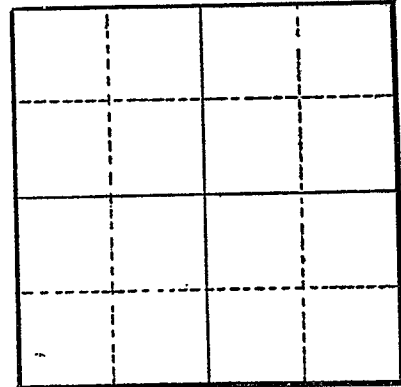

Altitude at well

TYPE OF WELL: dug Date Constructed 1926
drilled

Depth drilled 36 Depth cased 14

Section

CASING RECORD:

12-inch

FINISH:

AQUIFERS:

Gravel

WATER LEVEL:

20-feet

PUMPING EQUIPMENT: Type Centrifugal H.P. 10
Capacity 256 G.P.M.

WELL TESTS: 12 ft. after hours Pumping 256 G.P.M.
Drawdown hours G.P.M.
Drawdown hours G.P.M.

USE OF WATER irrigation Temp. °F. 19

SOURCE OF INFORMATION GR-2719

DRILLER or DIGGER

ADDITIONAL DATA:

Log X Water Level Measurements Chemical Analysis Aquifer Test

REMARKS:

Gravel