

STATE ENGINEER
Salem, Oregon

MAR 15 1950

Well Record

GR- 1213

STATE WELL NO. 9/3W-30K ✓
COUNTY Marion
APPLICATION NO. GR- 1257

OWNER: Ernest J. Freeman


MAILING ADDRESS: Rt. 1

LOCATION OF WELL: Owner's No. #2

CITY AND STATE: Jefferson, Oregon

NW ¼ SE ¼ Sec. 30 T. 9 S, R. 3 W., W.M.

Bearing and distance from section or subdivision corner 1452' N. & 396' E. from S ¼ cor. Sec. 30.

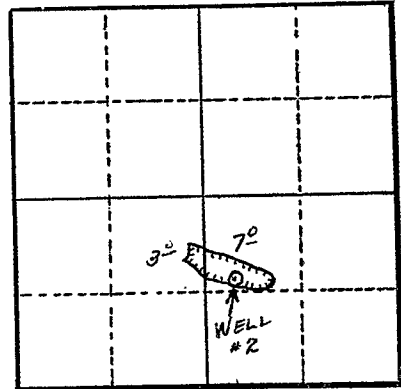

Section 30

Altitude at well 185 ft.

TYPE OF WELL: Drilled Date Constructed 1951

Depth drilled 20 ft. Depth cased 20 ft.

CASING RECORD:

8 inch

FINISH:

Slotted perforations from 14 to 20 ft.

AQUIFERS:

WATER LEVEL:

10 ft.

PUMPING EQUIPMENT: Type F. M. Cent. H.P. 10

Capacity 200+ G.P.M.

WELL TESTS:

Drawdown 0 ft. after 200 hours G.P.M.

Drawdown ft. after hours G.P.M.

USE OF WATER Irrigation Temp. °F. 19

SOURCE OF INFORMATION G. R. Record

DRILLER or DIGGER Don't know

ADDITIONAL DATA:

Log Water Level Measurements Chemical Analysis Aquifer Test

REMARKS:

Log: Sandy loam 0 to 6 ft.
Coarse sand & gravel 6 to 20 ft.

Irrigation of 10 acres.