

STATE ENGINEER  
Salem, Oregon

*SSS*  
**MAR.**

# Well Record

STATE WELL NO. 9/3W-30L  
COUNTY Marion  
APPLICATION NO. GR-3310

OWNER: D. A. Davidson


MAILING ADDRESS: Route 1, Box 129

LOCATION OF WELL: Owner's No. \_\_\_\_\_

CITY AND STATE: Jefferson, Oregon

NE 1/4 SW 1/4 Sec. 30 T. 9 S, R. 3 W., W.M.

Bearing and distance from section or subdivision  
corner ch. N. & 31 ch. W.

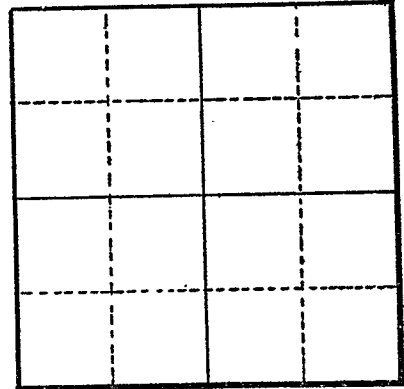

Section \_\_\_\_\_

Altitude at well \_\_\_\_\_

TYPE OF WELL: dug Date Constructed 1938

Depth drilled 16' Depth cased \_\_\_\_\_

### CASING RECORD:

### FINISH:

### AQUIFERS:

Loam, Sand, Gravel

### WATER LEVEL:

PUMPING EQUIPMENT: Type Rainflow H.P. 20  
Capacity 500 G.P.M.

WELL TESTS:  
Drawdown \_\_\_\_\_ ft. after \_\_\_\_\_ hours \_\_\_\_\_ G.P.M.  
Drawdown \_\_\_\_\_ ft. after \_\_\_\_\_ hours \_\_\_\_\_ G.P.M.

USE OF WATER Irrigation Temp. \_\_\_\_\_ °F. \_\_\_\_\_, 19\_\_\_\_\_

SOURCE OF INFORMATION GR-3072

DRILLER or DIGGER \_\_\_\_\_

ADDITIONAL DATA:  
Log  Water Level Measurements \_\_\_\_\_ Chemical Analysis \_\_\_\_\_ Aquifer Test \_\_\_\_\_

### REMARKS:

Loam 12  
Sand 1  
Gravel 3 16