

STATE ENGINEER
Salem, Oregon

1952
MAJ

Well Record

STATE WELL NO. 9/ 3W-30L
COUNTY Marion
APPLICATION NO. GR-3309

OWNER: D. A. Davidson


MAILING ADDRESS: Route 1, Box 129

LOCATION OF WELL: Owner's No. Pump Well #1

CITY AND STATE: Jefferson, Oregon

NE 1/4 SW 1/4 Sec. 30 T. 9 S., R. 3 W., W.M.

Bearing and distance from section or subdivision corner 9.7 ch. N. & 22.7 Ch. W.

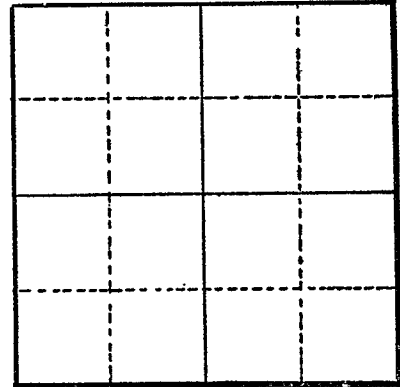

Section

Altitude at well

TYPE OF WELL: drilled Date Constructed 1953

Depth drilled 30' Depth cased

CASING RECORD:

FINISH:

AQUIFERS:

Loam, Sandy gravel & gravel

WATER LEVEL:

PUMPING EQUIPMENT: Type Rainflow H.P. 20
Capacity 500 G.P.M.

WELL TESTS:
Drawdown ft. after hours G.P.M.
Drawdown ft. after hours G.P.M.

USE OF WATER Irrigation Temp. °F., 19

SOURCE OF INFORMATION GR-3071

DRILLER or DIGGER

ADDITIONAL DATA:
Log Water Level Measurements Chemical Analysis Aquifer Test

REMARKS:

Loam 6
Sandy Gravel 4
Gravel 20 30