

STATE ENGINEER
Salem, Oregon

M 171...
1533

Well Record


STATE WELL NO. 9/3W-300
COUNTY Marion
APPLICATION NO. GR-3314

OWNER: Chester A. Myers
MAILING ADDRESS:

LOCATION OF WELL: Owner's No. _____
CITY AND STATE: Jefferson, Oregon

SW 1/4 SE 1/4 Sec. 30 T. 9 S. R. 3 W., W.M.

Bearing and distance from section or subdivision
corner 14.6 chs. E. & 18.0 chs. N. from S 1/4 Cor. Sec. 30

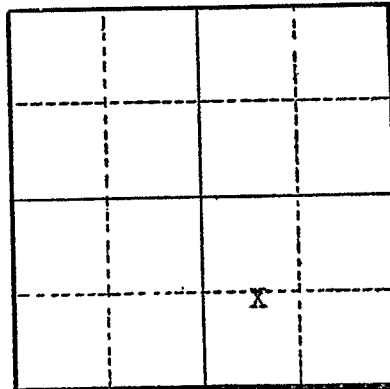

Section 30

Altitude at well _____

TYPE OF WELL: Drilled Date Constructed 1945

Depth drilled 28 ft. Depth cased 28 ft.

CASING RECORD:

10 inch steel casing set to 28 feet

FINISH:

AQUIFERS:

WATER LEVEL:

13 feet below surface

PUMPING EQUIPMENT: Type Fairbanks Morse H.P. 10
Capacity 240 G.P.M.

WELL TESTS:

Drawdown _____ ft. after _____ hours _____ G.P.M.
Drawdown _____ ft. after _____ hours _____ G.P.M.

USE OF WATER Irrigation _____ Temp. _____ °F. _____, 19____

SOURCE OF INFORMATION Well Registration Statement Cert. # GR-3794

DRILLER or DIGGER Fred Wymore

ADDITIONAL DATA:

Log _____ Water Level Measurements _____ Chemical Analysis _____ Aquifer Test _____

REMARKS: