

STATE ENGINEER
Salem, Oregon

15355
MAR 21 1942

Well Record

STATE WELL NO. 9/3W-300
COUNTY Marion
APPLICATION NO. GR-1258

GR- 1214

OWNER: Ernest J. Freeman


MAILING ADDRESS: Rt. 1

LOCATION OF WELL: Owner's No. #1

CITY AND STATE: Jefferson, Oregon

SW 1/4 SE 1/4 Sec. 30 T. 9 S. R. 3 W., W.M.

Bearing and distance from section or subdivision corner 858' N. & 66' E. from S 1/4 cor. Sec. 30.

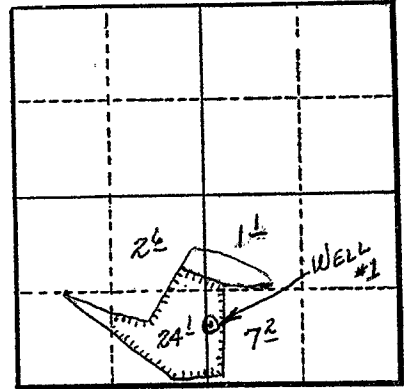

Section 30

Altitude at well 185 ft.

TYPE OF WELL: Drilled Date Constructed 1942

Depth drilled 25 ft. Depth cased 25 ft.

CASING RECORD:

4 x 4 ft. dug pit from 0 to 4 ft.
10 in. casing from 4 to 25 ft.

FINISH:

Perforated with slots from 10 to 25 ft.

AQUIFERS:

WATER LEVEL:

12 to 16 ft.

PUMPING EQUIPMENT: Type Western Electric H.P. 15
Capacity 700 G.P.M.

WELL TESTS:

Drawdown ft. after hours G.P.M.
Drawdown ft. after hours G.P.M.

USE OF WATER Irrigation Temp. °F. 19

SOURCE OF INFORMATION G. R. Record

DRILLER or DIGGER Wymore

ADDITIONAL DATA:

Log Water Level Measurements Chemical Analysis Aquifer Test

REMARKS:

Log: Sandy loam 0 to 6 ft.
Coarse sand & gravel 6 to 25 ft.

Irrigation of 35 acres.