

STATE ENGINEER
Salem, Oregon

MARION
15363

Well Record

STATE WELL NO. 9/3W-31K
COUNTY MARION
APPLICATION NO. GR-2962

OWNER: Don L. Turnidge


MAILING ADDRESS: Rt. 1, Jefferson, Oregon

LOCATION OF WELL: Owner's No.

CITY AND STATE:

NW 1/4 SE 1/4 Sec. 31 T. 9 N. S. R. 3 W., W.M.

Bearing and distance from section or subdivision corner 960' E. and 840' S.

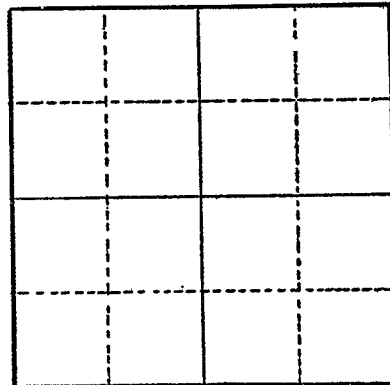

Altitude at well

TYPE OF WELL: drilled Date Constructed 1948

Depth drilled 20 Depth cased 20

Section

CASING RECORD:

8-inch

FINISH:

No perforations from 0 to 12
Slited with cutting torch 12 to 20

AQUIFERS:

Loam Soil 12 to 12
Gravel 8 to 20

WATER LEVEL:

10-feet

PUMPING EQUIPMENT: Type Centrifugal H.P. 15
Capacity 450 G.P.M.

WELL TESTS:

Drawdown 1 ft. after hours Pumping 500 G.P.M.
Drawdown 3 ft. after hours Pumping 1000 G.P.M.

USE OF WATER irrigation Temp. °F. 19

SOURCE OF INFORMATION GR-2779

DRILLER or DIGGER

ADDITIONAL DATA:

Log X Water Level Measurements Chemical Analysis Aquifer Test

REMARKS:

Loam soil 12 12
Gravel 8 20