

STATE ENGINEER
Salem, Oregon

Well Record

STATE WELL NO. 9/3W-32A(1)
COUNTY Marion
APPLICATION NO. GR-469

*M 171...
1936 7*

OWNER: El Rancho Menta


MAILING ADDRESS: Rt. 1

LOCATION OF WELL: Owner's No. 1

CITY AND STATE: Jefferson, Oregon

NE 1/4 NE 1/4 Sec. 32 T. 9 S., R. 3 W., W.M.

Bearing and distance from section or subdivision corner 630' S. & 260' W. from NE cor. of sec 32

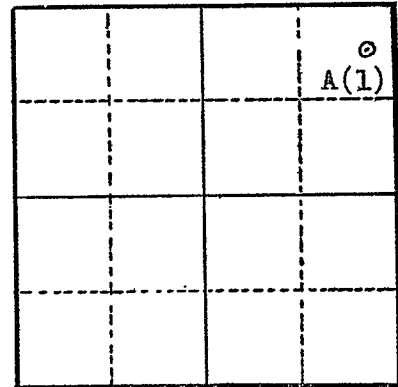

Altitude at well 195'

TYPE OF WELL: Drilled Date Constructed 1951

Depth drilled 27' Depth cased 27'

Section 32

CASING RECORD:

12 inch set from 7'6" to 27'

FINISH:

AQUIFERS:

Gravel from 16 to 27 feet

WATER LEVEL:

9 feet below land surface (4/15/57)

PUMPING EQUIPMENT: Type F. M. Centrifugal 4" X 5" H.P. 30
Capacity 600 G.P.M.

WELL TESTS:

Drawdown ft. after hours G.P.M.
Drawdown ft. after hours G.P.M.

USE OF WATER Irrigation (109.77 acres) Temp. °F., 19.....

SOURCE OF INFORMATION GR-451

DRILLER or DIGGER Bill Hamilton

ADDITIONAL DATA:

Log X Water Level Measurements Chemical Analysis Aquifer Test

REMARKS:

Top soil 0 to 12
Sand & gravel 12 to 16
Gravel 16 to 27