

STATE ENGINEER
Salem, Oregon

Well Record

STATE WELL NO. 9/3W-33H(1)
COUNTY Marion
APPLICATION NO. GR-466

15377
MARI.

OWNER: Arthur C. White


MAILING ADDRESS: Rt. 1 Box 169

LOCATION OF WELL: Owner's No. 1

CITY AND STATE: Jefferson, Oregon

SE $\frac{1}{4}$ NE $\frac{1}{4}$ Sec. 33 T. 9 XX S., R. 3 XX W., W.M.

Bearing and distance from section or subdivision corner 1121.5' N.9°23'W. from SE cor. of the John Harrison DIC #56

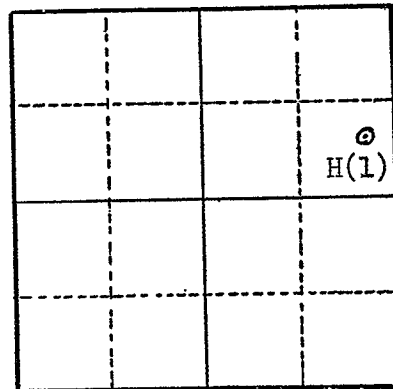

Altitude at well 199'

TYPE OF WELL: Drilled Date Constructed July 1948

Depth drilled 31' Depth cased 31'

Section 33

CASING RECORD:

8 inch set from +8" above land surface to 31 feet

FINISH:

Torch cut slots 12" X $\frac{1}{4}$ " - 4 rows - set from 20 to 31 feet

AQUIFERS:

Gravel from 20 to 31 feet

WATER LEVEL:

12 feet below land surface (July 1948)

PUMPING EQUIPMENT: Type Centrifugal H.P. 15
Capacity 300 G.P.M.

WELL TESTS:

Drawdown	$\frac{1}{2}$	ft. after	hours	<u>250</u>	G.P.M.
Drawdown	<u>2</u>	ft. after	hours	<u>500</u>	G.P.M.

USE OF WATER Irrigation (62 acres) Temp. °F. 19

SOURCE OF INFORMATION GR-448

DRILLER or DIGGER

ADDITIONAL DATA:

Log X Water Level Measurements Chemical Analysis Aquifer Test

REMARKS:

Top soil - sand with a few pebbles	0 to 3
Sand & silt, yellow	3 to 15
Gravel, cement	15 to 20
Gravel, water bearing	20 to 31