

STATE ENGINEER  
Salem, Oregon

# Well Record

STATE WELL NO. 9/3W-34E(1)  
COUNTY Marion  
APPLICATION NO. GR-405

*M. L. Turnidge*  
*15423*

OWNER: Dale L. Turnidge


MAILING ADDRESS: Rt. 1

LOCATION OF WELL: Owner's No. 12

CITY AND STATE: Jefferson, Oregon

SW  $\frac{1}{4}$  NW  $\frac{1}{4}$  Sec. 34 T. 9 S., R. 3 W., W.M.

Bearing and distance from section or subdivision corner 2390' N. & 435' E. from SW cor. of sec. 34

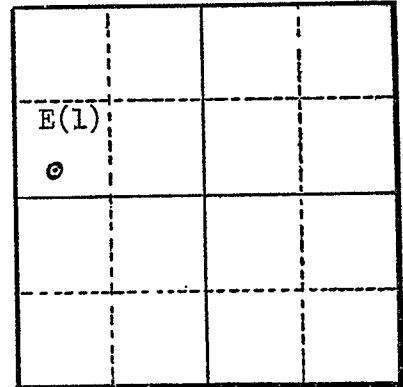

Altitude at well 195'

TYPE OF WELL: Drilled Date Constructed 1946

Depth drilled 40' Depth cased 40'

Section 34

### CASING RECORD:

12 inch set from 0 to 40 feet

### FINISH:

torch cut slots (8"x $\frac{1}{2}$ ") - 4 rows per foot from 32 to 40 feet

### AQUIFERS:

Sand & gravel from 32 to 40 feet

### WATER LEVEL:

16 feet below land surface

PUMPING EQUIPMENT: Type F. M. Centrifugal H.P. 15  
Capacity 450 G.P.M.

### WELL TESTS:

Drawdown ..... ft. after ..... hours ..... G.P.M.  
Drawdown ..... ft. after ..... hours ..... G.P.M.

USE OF WATER Irrigation (94 acres) Temp. ..... °F. ...., 19.....

SOURCE OF INFORMATION GR-388

DRILLER or DIGGER .....

### ADDITIONAL DATA:

Log  Water Level Measurements ..... Chemical Analysis ..... Aquifer Test .....

### REMARKS:

Sandy loam 0 to 8  
Sand & gravel 8 to 40