

STATE ENGINEER  
Salem, Oregon

15424  
MARI.....

# Well Record

STATE WELL NO. 9/3W-34E ✓  
COUNTY Marion  
APPLICATION NO. GR-1575

GR-1517

OWNER: Ammon Bros.

MAILING ADDRESS:

LOCATION OF WELL: Owner's No. #1


CITY AND STATE:

Jefferson, Oregon

SE 1/4 NW 1/4 Sec. 34 T. 9 S. R. 3 W., W.M.

Bearing and distance from section or subdivision

corner N. 18° 45' W. 43.5 ch. from SE cor. SW 1/4 Sec. 34

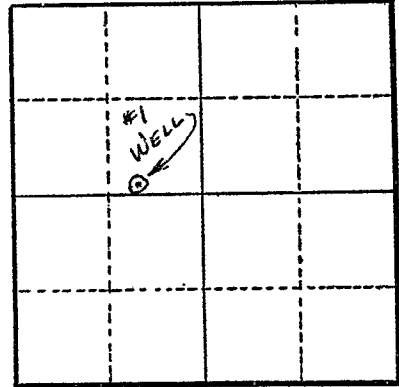

Section 34

Altitude at well 200

TYPE OF WELL: Drilled Date Constructed 1950

Depth drilled 30' Depth cased 30'

CASING RECORD:

10"

FINISH:

Slot perforations from 24 to 30 ft.

AQUIFERS:

WATER LEVEL:

10'

PUMPING EQUIPMENT: Type F. M. 3" Cent.

H.P. 20

Capacity 300 G.P.M.

WELL TESTS:

Drawdown 7 ft. after 400 hours G.P.M.

Drawdown ft. after hours G.P.M.

USE OF WATER Irrigation Temp. °F. 19

SOURCE OF INFORMATION GR Record

DRILLER or DIGGER

ADDITIONAL DATA:

Log N.A. Water Level Measurements Chemical Analysis Aquifer Test

REMARKS:

Irrigation of 30.2 acres.