

STATE ENGINEER  
Salem, Oregon

MAILED  
13425

# Well Record

GR- 1518

STATE WELL NO. 9/3W-34E  
COUNTY Marion  
APPLICATION NO. GR- 1576

OWNER: Ammon Bros.

MAILING  
ADDRESS:


LOCATION OF WELL: Owner's No. #2

CITY AND  
STATE:

Jefferson, Oregon

SE 1/4 NW 1/4 Sec. 34 T. 9 S., R. 3 W., W.M.

Bearing and distance from section or subdivision  
corner N.10°45'W. 46.25 ch. from S 1/4 cor. Sec. 34

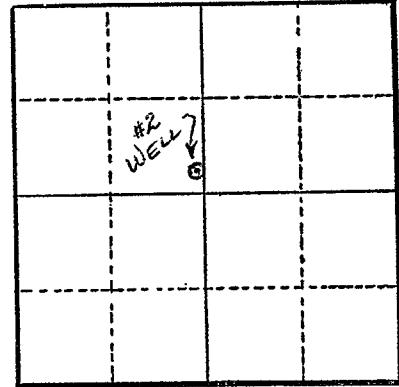

Section 34

Altitude at well 200'

TYPE OF WELL: Drilled Date Constructed 1954

Depth drilled 30' Depth cased 30'

CASING RECORD:

10"

FINISH:

Slot perforations from 24 to 30 ft.

AQUIFERS:

WATER LEVEL:

5'

PUMPING EQUIPMENT: Type Pacific 3" Cent. H.P. 20  
Capacity 400 G.P.M.

WELL TESTS:

Drawdown 5 ft. after 500 hours G.P.M.

Drawdown \_\_\_\_\_ ft. after \_\_\_\_\_ hours G.P.M.

USE OF WATER Irrigation Temp. \_\_\_\_\_ °F. \_\_\_\_\_, 19\_\_\_\_\_

SOURCE OF INFORMATION GR Record

DRILLER or DIGGER Nicholas Klaus

ADDITIONAL DATA:

Log N.A. Water Level Measurements \_\_\_\_\_ Chemical Analysis \_\_\_\_\_ Aquifer Test \_\_\_\_\_

REMARKS:

Irrigation of 36.7 acres.