

STATE ENGINEER  
Salem, Oregon

15428  
MARI

# Well Record

GR-1519

STATE WELL NO. 9/3W-34K  
COUNTY Marion  
APPLICATION NO. GR-1577

OWNER: Ammon Bros.

MAILING ADDRESS:

LOCATION OF WELL: Owner's No. #3


CITY AND STATE:

Jefferson, Oregon

NW 1/4 SE 1/4 Sec. 34 T. 9 S. R. 3 W., W.M.

Bearing and distance from section or subdivision

corner N. 14° 40' E. 39 ch. from SW cor. of SE 1/4 Sec. 34

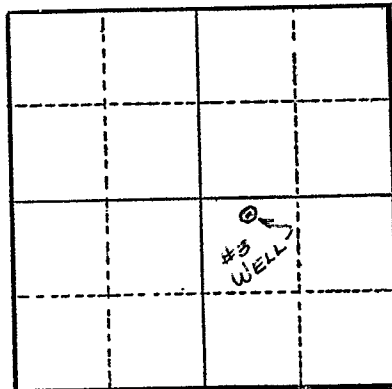

Section 34

Altitude at well 200'

TYPE OF WELL: Drilled Date Constructed 1954

Depth drilled 30' Depth cased 30'

### CASING RECORD:

10"

### FINISH:

Slot perforations from 24 to 30 ft.

### AQUIFERS:

### WATER LEVEL:

8'

PUMPING EQUIPMENT: Type Berkeley 2" Cent. H.P. 10  
Capacity 250 G.P.M.

### WELL TESTS:

Drawdown 8 ft. after 200 hours G.P.M.  
Drawdown ft. after hours G.P.M.

USE OF WATER Irrigation Temp. °F. 19

SOURCE OF INFORMATION GR Record

DRILLER or DIGGER Nicholas Klaus

### ADDITIONAL DATA:

Log N.A. Water Level Measurements Chemical Analysis Aquifer Test

### REMARKS:

Irrigation of 19.5 acres.