

STATE ENGINEER
Salem, Oregon

15429
M 121.....

Well Record


STATE WELL NO. 9/3W-34K
COUNTY Marion
APPLICATION NO. GR-496

OWNER: Ralph Nelson
MAILING ADDRESS: _____

LOCATION OF WELL: Owner's No. 4
CITY AND STATE: Jefferson, Oregon

NW 1/4 SE 1/4 Sec. 34 T. 9 N. S., R. 3 E. W.M.

Bearing and distance from section or subdivision corner
1850 feet North and 590 feet East from the S/4 Corner, Section 34.

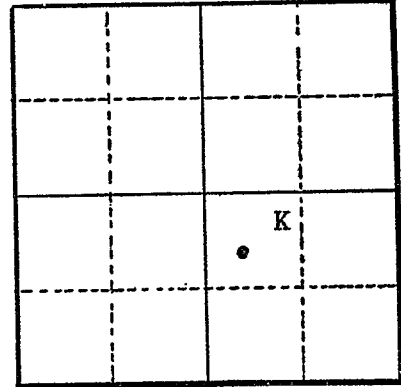

Altitude at well 225 feet

TYPE OF WELL: Drilled Date Constructed 1955

Depth drilled 34 feet Depth cased 34 feet

Section 34

CASING RECORD:

8-inch casing set from top to 34 feet

FINISH:

perforated from 19 to 34 feet

AQUIFERS:

gravel and sand

WATER LEVEL:

13 feet

PUMPING EQUIPMENT: Type Fairbanks H.P. _____
Capacity 360 G.P.M.

WELL TESTS:

Drawdown 12 ft. after _____ hours 360 G.P.M.
Drawdown _____ ft. after _____ hours _____ G.P.M.

USE OF WATER Irrigation Temp. _____ °F. _____, 19
SOURCE OF INFORMATION GR-4139

DRILLER or DIGGER _____

ADDITIONAL DATA:

Log (NA) Water Level Measurements _____ Chemical Analysis _____ Aquifer Test _____

REMARKS: