

STATE ENGINEER
Salem, Oregon

MARION
15430

Well Record

STATE WELL NO. 9/3W-34L
COUNTY Marion
APPLICATION NO. GR-496

OWNER: Ralph Nelson


MAILING ADDRESS:

LOCATION OF WELL: Owner's No. 2

CITY AND STATE: Jefferson, Oregon

NE 1/4 SW 1/4 Sec. 34 T. 9 N. S. R. 3 W., W.M.

Bearing and distance from section or subdivision corner
1740 feet East and 1520 feet North
from the SW Corner, Section 34

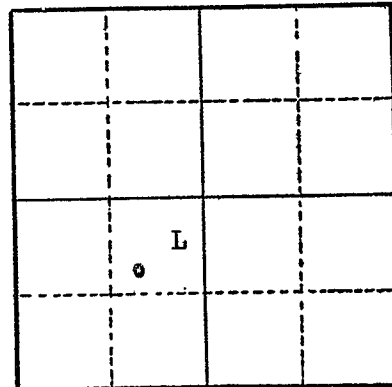

Section 34

Altitude at well 225 feet

TYPE OF WELL: Drilled Date Constructed 1945
Depth drilled 30 feet Depth cased

CASING RECORD:

8-inch casing

FINISH:

perforations

AQUIFERS:

sand and gravel

WATER LEVEL:

12 feet

PUMPING EQUIPMENT: Type Fairbanks H.P.
Capacity 260 G.P.M.

WELL TESTS:

Drawdown 14 ft. after 250 hours G.P.M.
Drawdown ft. after hours G.P.M.

USE OF WATER Irrigation Temp. °F. 19

SOURCE OF INFORMATION GR-4139

DRILLER or DIGGER

ADDITIONAL DATA:

Log Water Level Measurements Chemical Analysis Aquifer Test

REMARKS:

Gravel and sand full depth