

STATE ENGINEER
Salem, Oregon

MAR.

115433

Well Record

STATE WELL NO. 9/3W-34P
COUNTY Marion
APPLICATION NO. GR-496

OWNER: Ralph Nelson

MAILING ADDRESS:


LOCATION OF WELL: Owner's No. 1

CITY AND STATE:

Jefferson, Oregon

SE 1/4 SW 1/4 Sec. 34 T. 9 N. S., R. 3 E. W., W.M.

Bearing and distance from section or subdivision corner
1550 feet East and 660 feet North from the SW Corner, Section 34

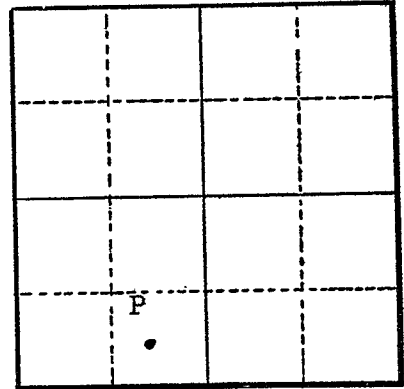

Section 34

Altitude at well 225 feet

TYPE OF WELL: Drilled Date Constructed 1945

Depth drilled 30 feet Depth cased 30 feet

CASING RECORD:

12-inch casing set from 1 to 30 feet

FINISH:

perforations from 15 ft. ?

AQUIFERS:

gravel and sand

WATER LEVEL:

12 feet

PUMPING EQUIPMENT: Type Fairbanks 3" x 4" H.P.
Capacity 360 G.P.M.

WELL TESTS:

Drawdown 8 ft. after 360 hours G.P.M.

Drawdown ft. after hours G.P.M.

USE OF WATER Irrigation Temp. °F., 19

SOURCE OF INFORMATION GR-4139

DRILLER or DIGGER

ADDITIONAL DATA:

Log (NA) Water Level Measurements Chemical Analysis Aquifer Test

REMARKS: