

STATE ENGINEER  
Salem, Oregon

~~1543~~  
MAR 21 1954

# Well Record


STATE WELL NO. 9/3W-34K(1)  
COUNTY Marion  
APPLICATION NO. GR-404

OWNER: Dale Turnidge MAILING ADDRESS: Rt. 1

LOCATION OF WELL: Owner's No. 4 CITY AND STATE: Jefferson, Oregon

NW 1/4 SE 1/4 Sec. 34 T. 9 S., R. 3 W., W.M.

Bearing and distance from section or subdivision corner 1340' N. & 1975' W. of SE cor. of sec. 34

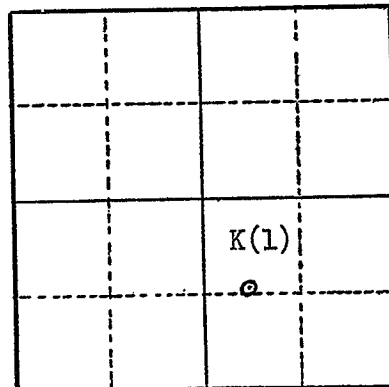

Altitude at well 205'

TYPE OF WELL: Drilled Date Constructed 1954

Depth drilled 32' Depth cased 32'

Section 34

### CASING RECORD:

12 inch set from 0 to 32 feet

### FINISH:

Torch cut slots (10"x $\frac{1}{2}$ " - 4/foot) set from 24 to 32 feet

### AQUIFERS:

Sand & gravel from 6 to 32 feet

### WATER LEVEL:

16 feet below land surface

PUMPING EQUIPMENT: Type F. M. Centrifugal H.P. 15  
Capacity 450 G.P.M.

### WELL TESTS:

Drawdown ..... ft. after ..... hours ..... G.P.M.  
Drawdown ..... ft. after ..... hours ..... G.P.M.

USE OF WATER Irrigation (89 acres) Temp. ..... °F. ...., 19.....

SOURCE OF INFORMATION GR-387

### DRILLER or DIGGER

### ADDITIONAL DATA:

Log X Water Level Measurements ..... Chemical Analysis ..... Aquifer Test .....

### REMARKS:

Sandy loam 0 to 6  
Sand & gravel 6 to 32