

STATE ENGINEER  
Salem, Oregon

MARION **Well Record**

STATE WELL NO. 9/3W-34M(2)  
COUNTY Marion  
APPLICATION NO. GR-405

OWNER: Dale L. Turnidge


MAILING ADDRESS: Rt. 1

LOCATION OF WELL: Owner's No. 10

CITY AND STATE: Jefferson, Oregon

NW 1/4 SW 1/4 Sec. 34 T. 9 S., R. 3 W., W.M.

Bearing and distance from section or subdivision corner 1765' N. & 525' E. of SW cor. of sec. 34

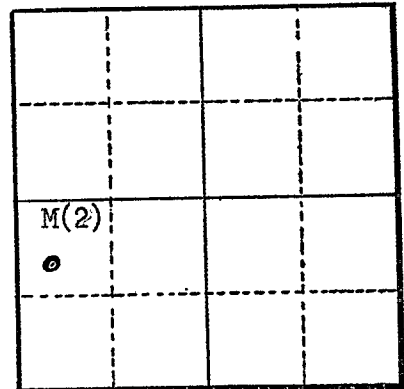

Section 34

Altitude at well 193'

TYPE OF WELL: Drilled Date Constructed 1944

Depth drilled 30' Depth cased 30'

CASING RECORD:

8 inch set from 0 to 30 feet

FINISH:

Torch cut slots (8"x1/2" - 1/ft.) from 24 to 30 feet

AQUIFERS:

Sand & gravel from 6 to 30 feet

WATER LEVEL:

12 feet below land surface

PUMPING EQUIPMENT: Type F. M. Centrifugal H.P. 10  
Capacity 250 G.P.M.

WELL TESTS:

Drawdown ft. after hours G.P.M.  
Drawdown ft. after hours G.P.M.

USE OF WATER Irrigation (9 1/2 acres) Temp. °F. 19

SOURCE OF INFORMATION GR-388

DRILLER or DIGGER

ADDITIONAL DATA:

Log X Water Level Measurements Chemical Analysis Aquifer Test

REMARKS:

Sandy loam 0 to 6  
Sand & gravel 6 to 30