

STATE ENGINEER  
Salem, Oregon

15437


# Well Record

STATE WELL NO. 9/3W-34N(1)  
COUNTY Marion  
APPLICATION NO. GR-405

OWNER: Dale L. Turnidge  
MAILING ADDRESS: Rt. 1

LOCATION OF WELL: Owner's No. 9  
CITY AND STATE: Jefferson, Oregon

SW 1/4 SW 1/4 Sec. 34 T. 9 S, R. 3 W., W.M.  
Bearing and distance from section or subdivision  
corner 1275'N. & 448'E. from SW cor. of sec. 34

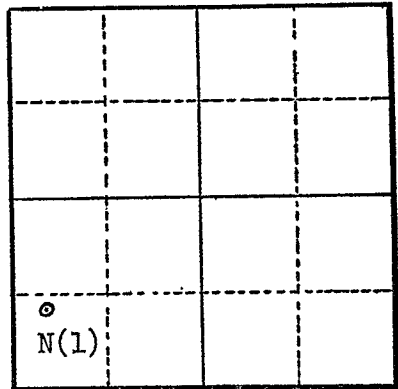

Altitude at well 193'

TYPE OF WELL: Drilled Date Constructed 1952  
Depth drilled 30' Depth cased 30'

Section 34

CASING RECORD:  
12 inch set from 0 to 30 feet

FINISH:  
Torch cut slots (8"x1/2" - 4/ft.) from 24 to 30 feet

AQUIFERS:  
Sand & gravel from 8 to 30 feet

WATER LEVEL:  
16 feet below land surface

PUMPING EQUIPMENT: Type F. M. H.P. 15  
Capacity 450 G.P.M.

WELL TESTS:  
Drawdown ft. after hours G.P.M.  
Drawdown ft. after hours G.P.M.

USE OF WATER Irrigation (94 acres) Temp. °F. 19

SOURCE OF INFORMATION GR-388

DRILLER or DIGGER  
ADDITIONAL DATA:  
Log  Water Level Measurements  Chemical Analysis  Aquifer Test

REMARKS:  
Sandy loam 0 to 8  
Sand & gravel 8 to 30